
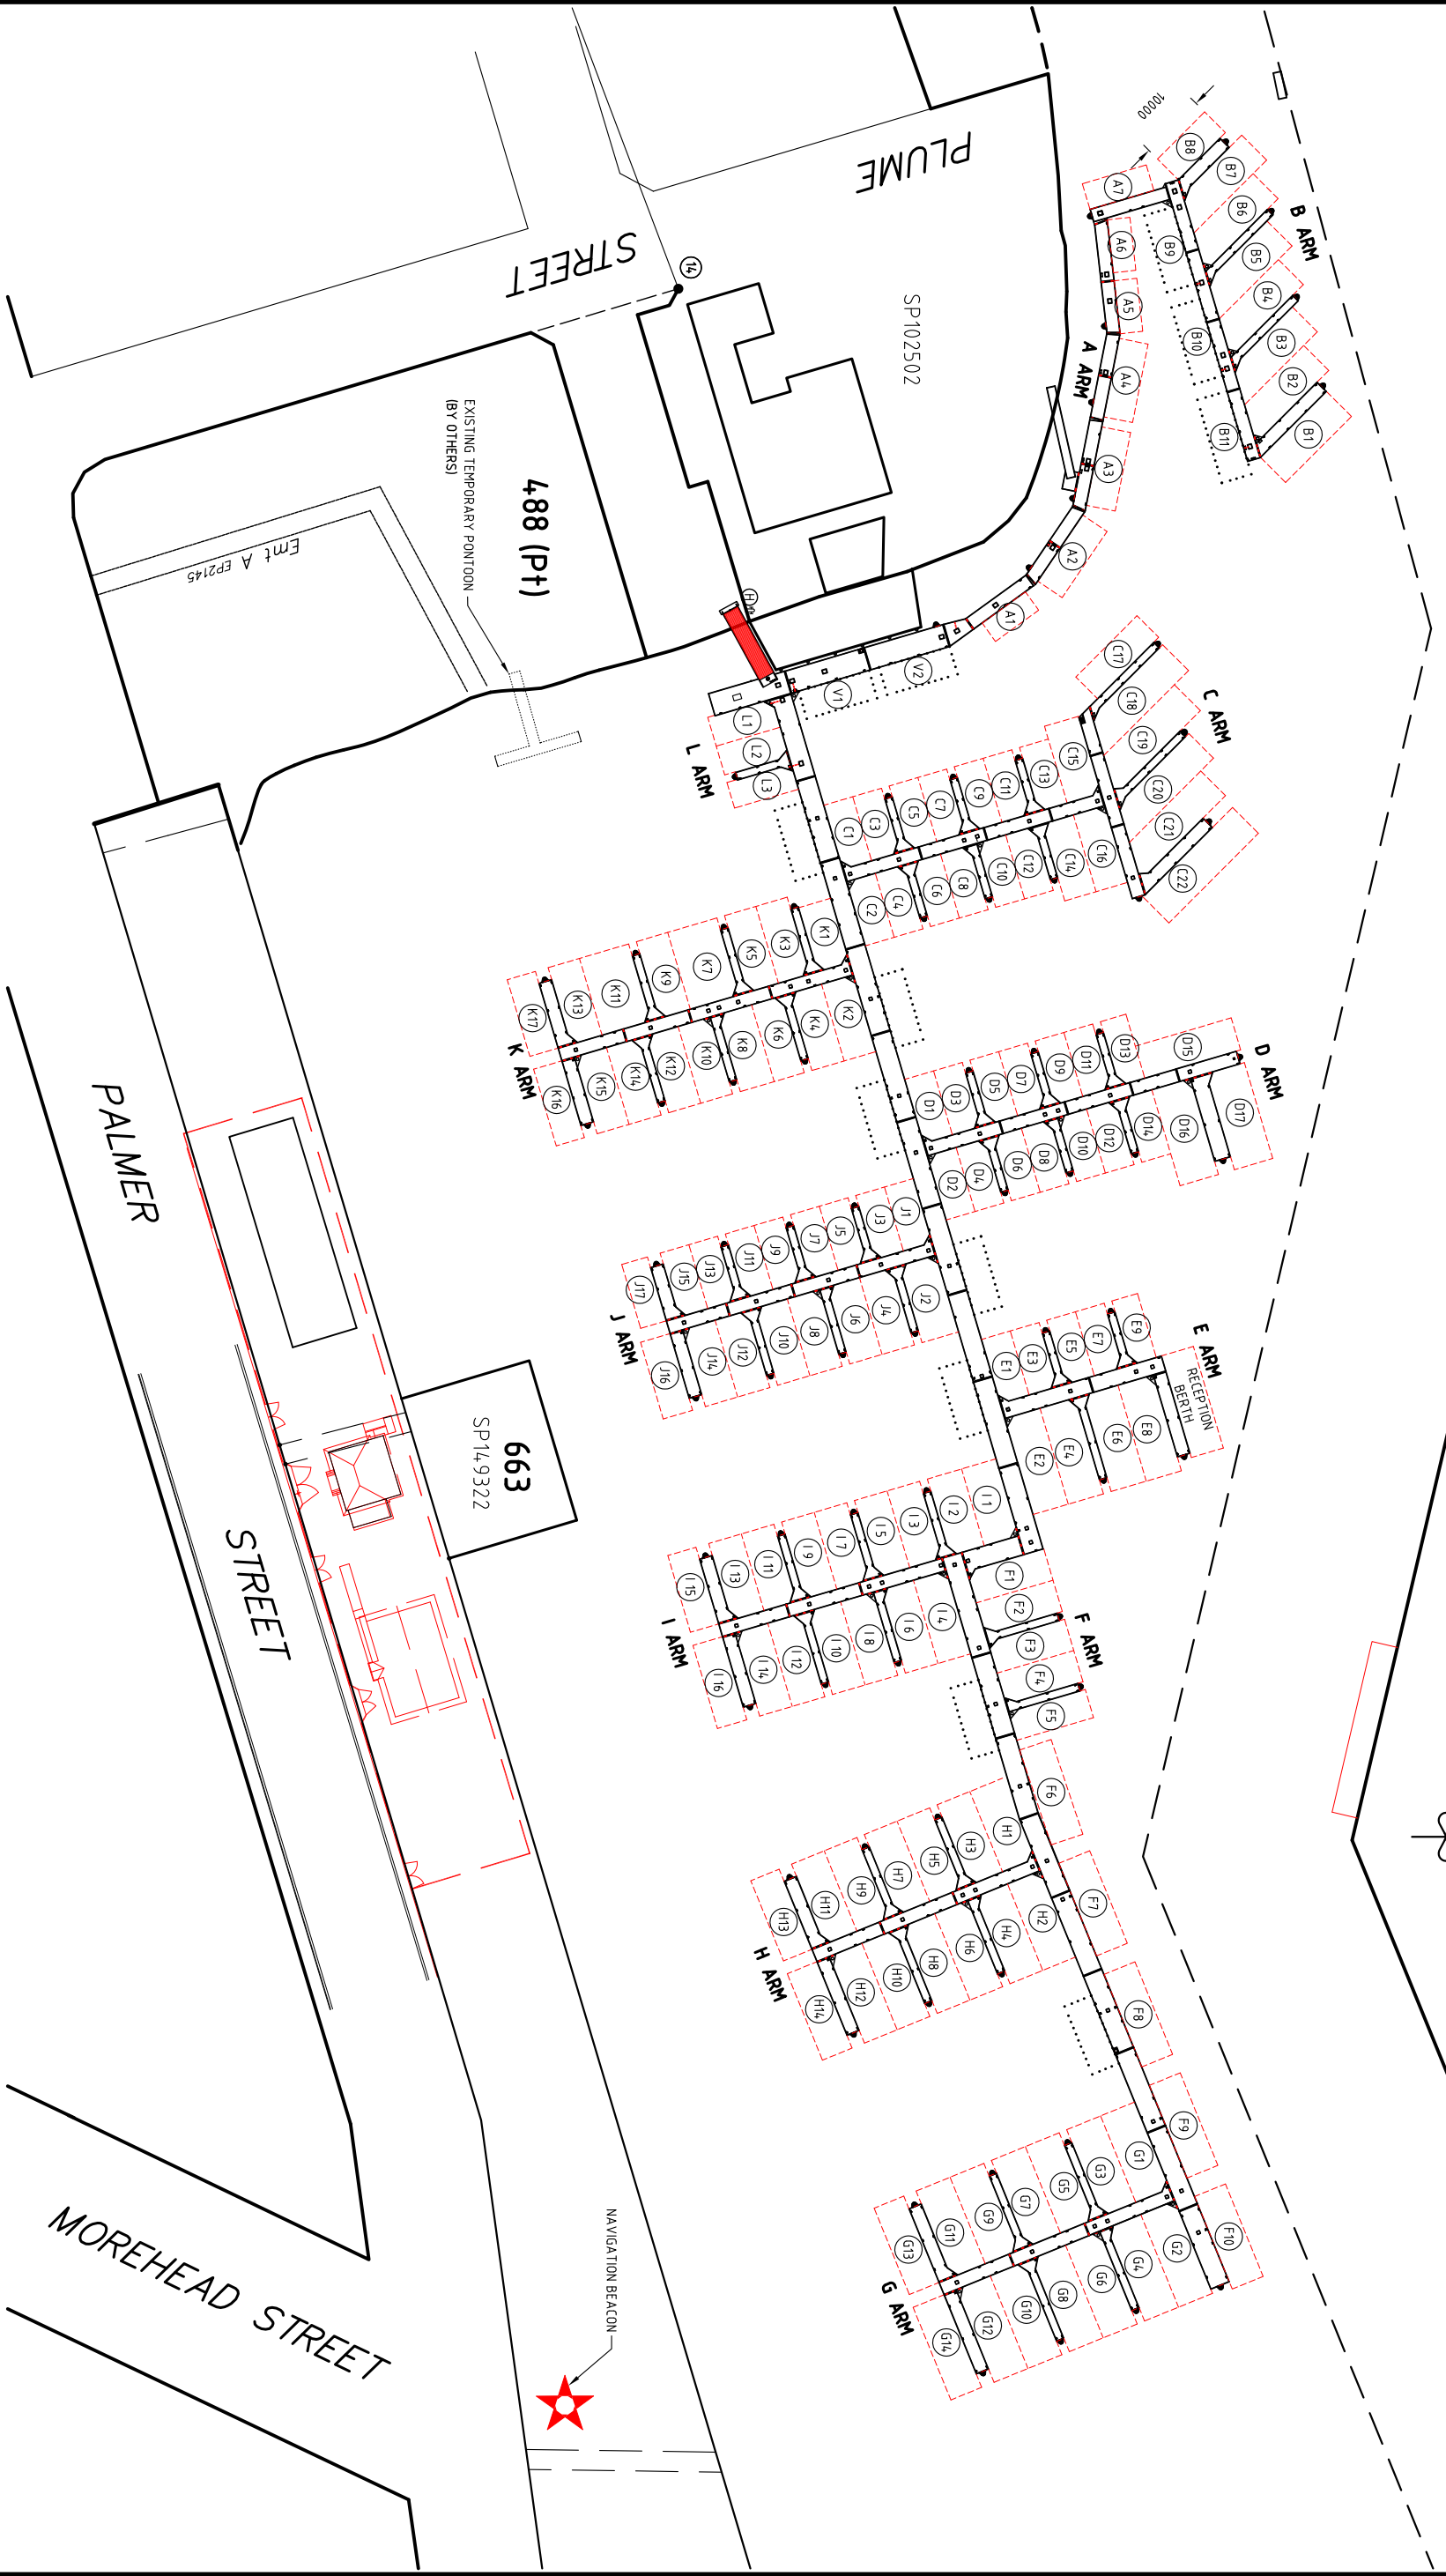


ROSS CREEK

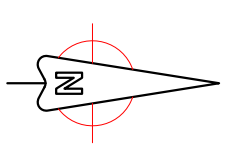

No.	DATE	REVISION

ATLAS MARINE INTERNATIONAL  
TRADING AS  
SUPERIOR JETTIES

COPYRIGHT © 2006 ATLAS MARINE INTERNATIONAL PTY. LTD. NO PART OF THIS DOCUMENT MAY BE COPIED, REPRODUCED, STORED IN A RETRIEVABLE SYSTEM IN ANY FORM, OR TRANSMITTED BY ANY MEANS WITHOUT PRIOR WRITTEN PERMISSION OF ATLAS MARINE INTERNATIONAL PTY. LTD.

**SUPERIOR**  
**jetties**

15 Jade Drive Nerang Qld Australia  
 Mail Address: P.O. Box 920 Nerang 4211  
 Ph: 07 55 97933  
 Fax: 07 55 97046  
 Email: info@superiorjetties.com

DATE	19/06/09
DRAWING NO.	3459-AC-01
REVISION NO.	

PROJECT	PROPOSED MARINA LAYOUT AS CONSTRUCTED MARINA LAYOUT
DRG. TITLE	
CLIENT	TOWNSVILLE MOTOR BOAT & YACHT CLUB LTD
ADDRESS	PLUME STREET TOWNSVILLE
DRAWN BY	DESIGNED
D.G.G.	S.R.B.
PAPER SIZE	A3
SCALE	1 : 1000
FILE NAME	

INDICATIVE ONLY  
SUBJECT TO FINAL  
ENGINEERS  
SPECIFICATIONS  
AND APPROVAL